


150 TOWER

Minneapolis, Minnesota

FIFTH  STREET
TOWERS

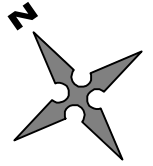

SUITE 1360 - SUITE AS-BUILT PLAN

1/16" = 1'-0"

