



150 TOWER

Minneapolis, Minnesota



SUITE 1435 - SUITE AS-BUILT PLAN

1/8" = 1'-0"

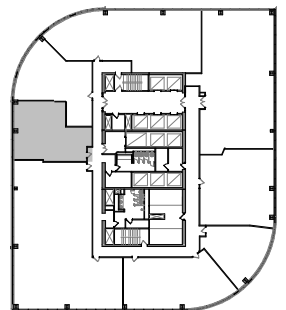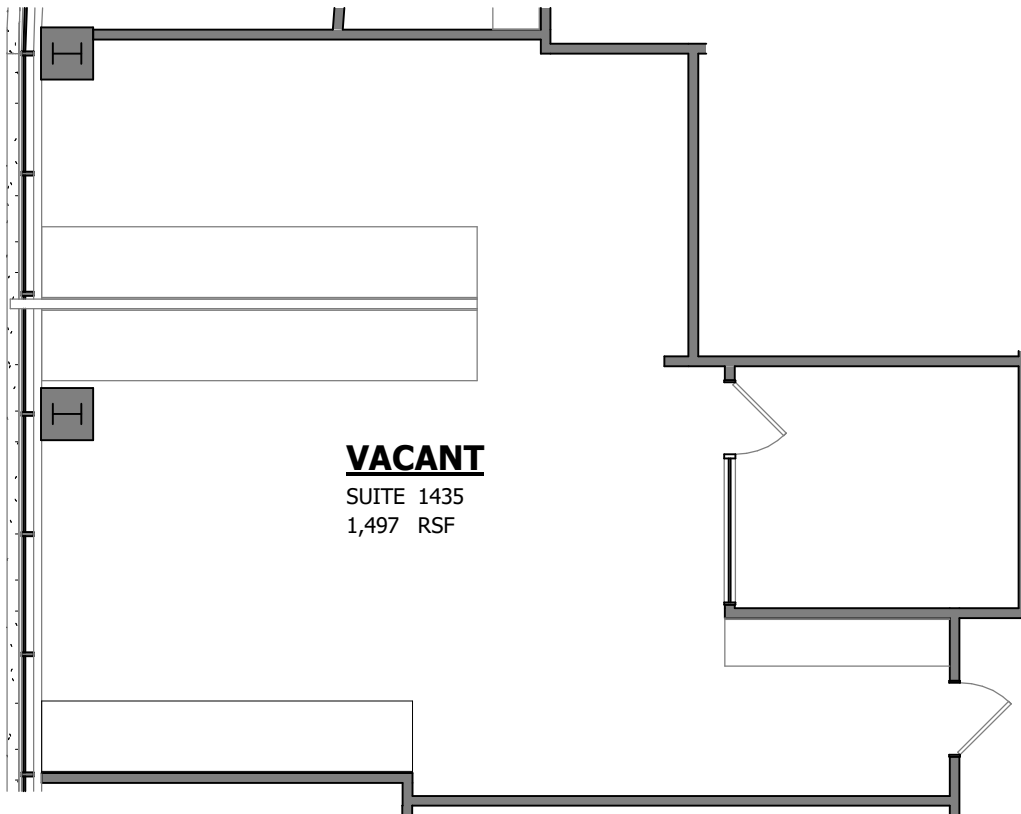

Zeller Realty Group®

NELSON

Issue Date: 08.12.2024